1	2	3	4	5	6	7	8	9	0

COMPUTER AIDED DRAWING – AVOID MANUAL MODIFICATION

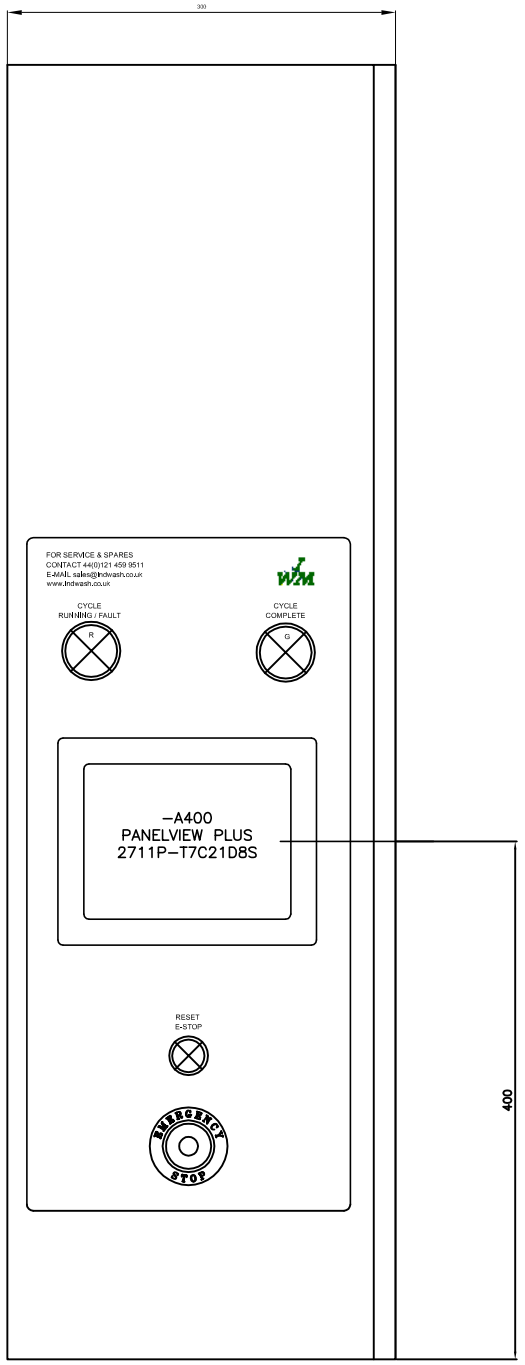

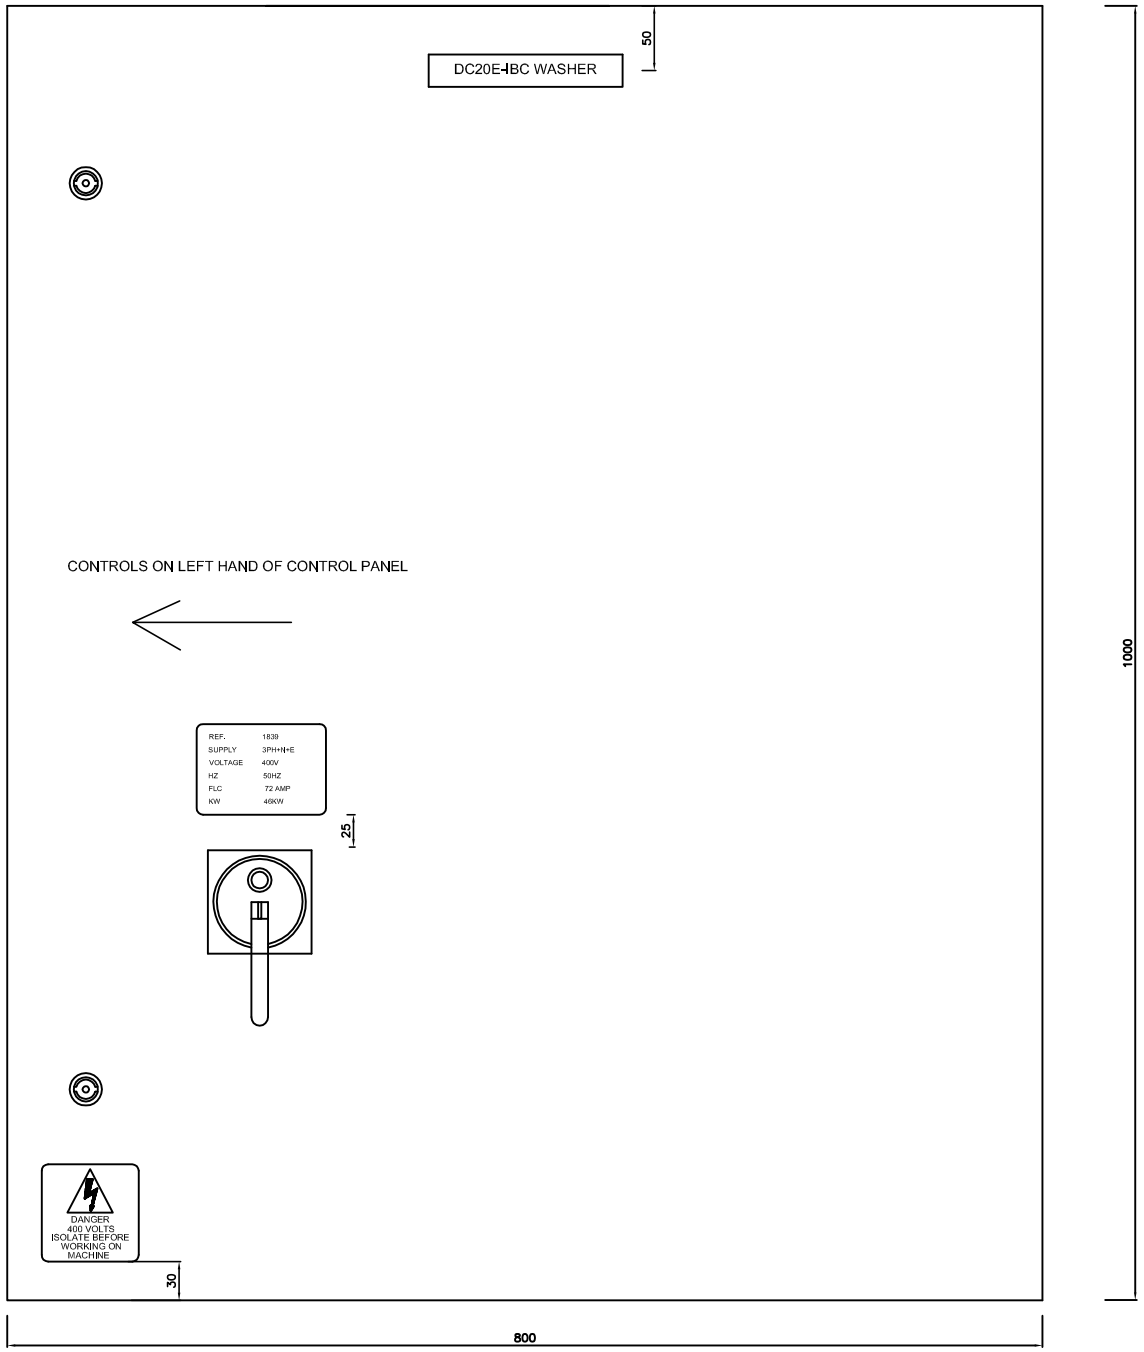

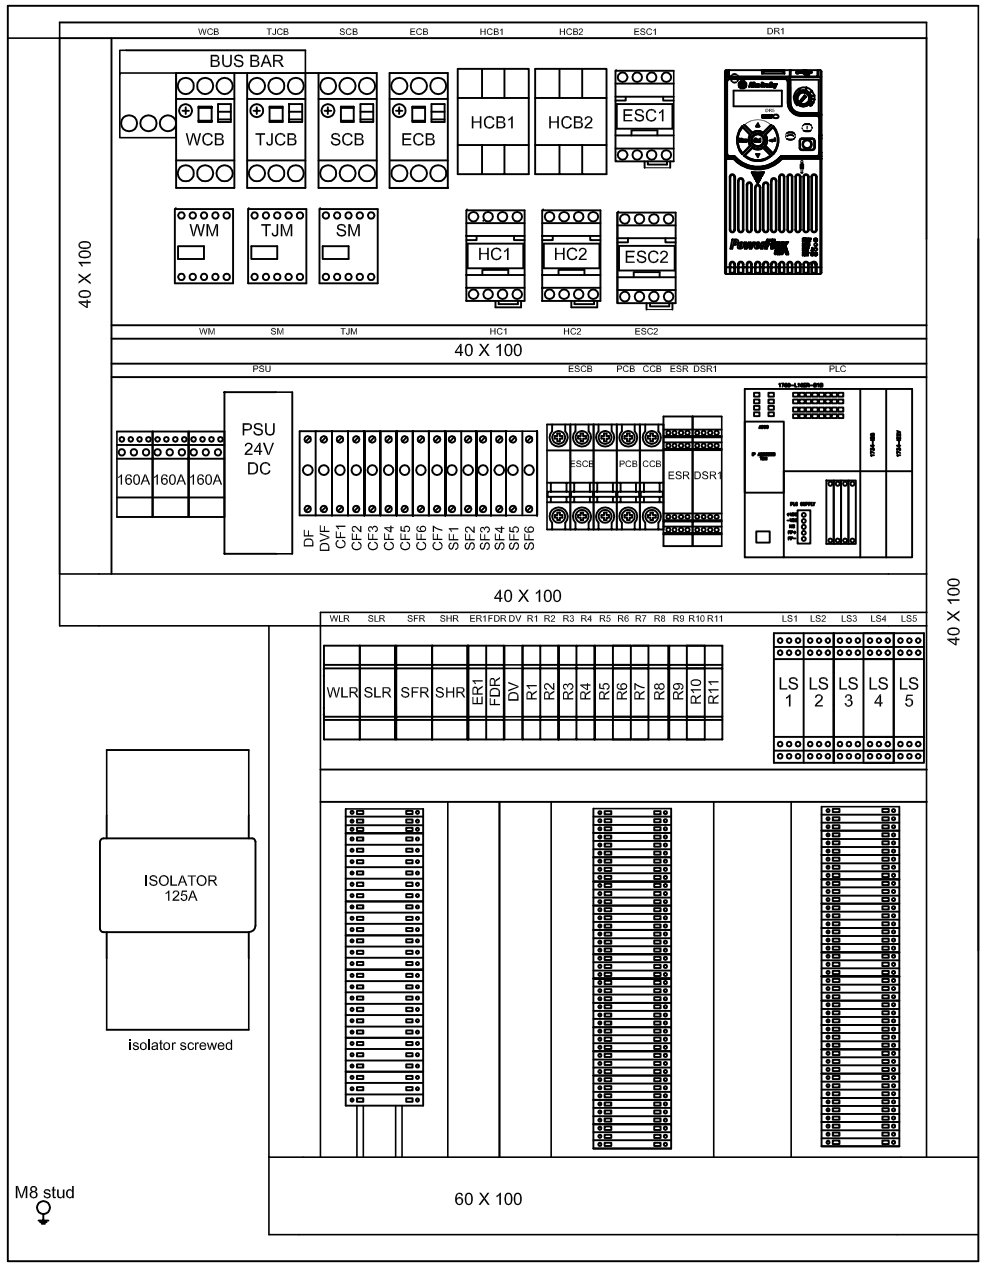

03			
02	AS BUILT	GCB	06.11.19
01	FOR APPROVAL	GCB	04.10.19
ISSUES		INT'L	DATE

INDUSTRIAL WASHING MACHINES (UK)

IWM

FACET ROAD,KINGS NORTON
BIRMINGHAM,B38 9PT
TEL. 0121 4599511
FAX. 0121 4599001

DRAWN	CHECKED
GCB	EK

APPROVED
DAN

TITLE

SC JOHNSON
DC20E-IBC WASHER
JOB No 1839

DRAWING NO: ESJN5246 CAD#

SHEET 1

NO. OF SHEETS 1

DATE OF ISSUE 04.10.19

ISSUE
01